


EXHIBIT H

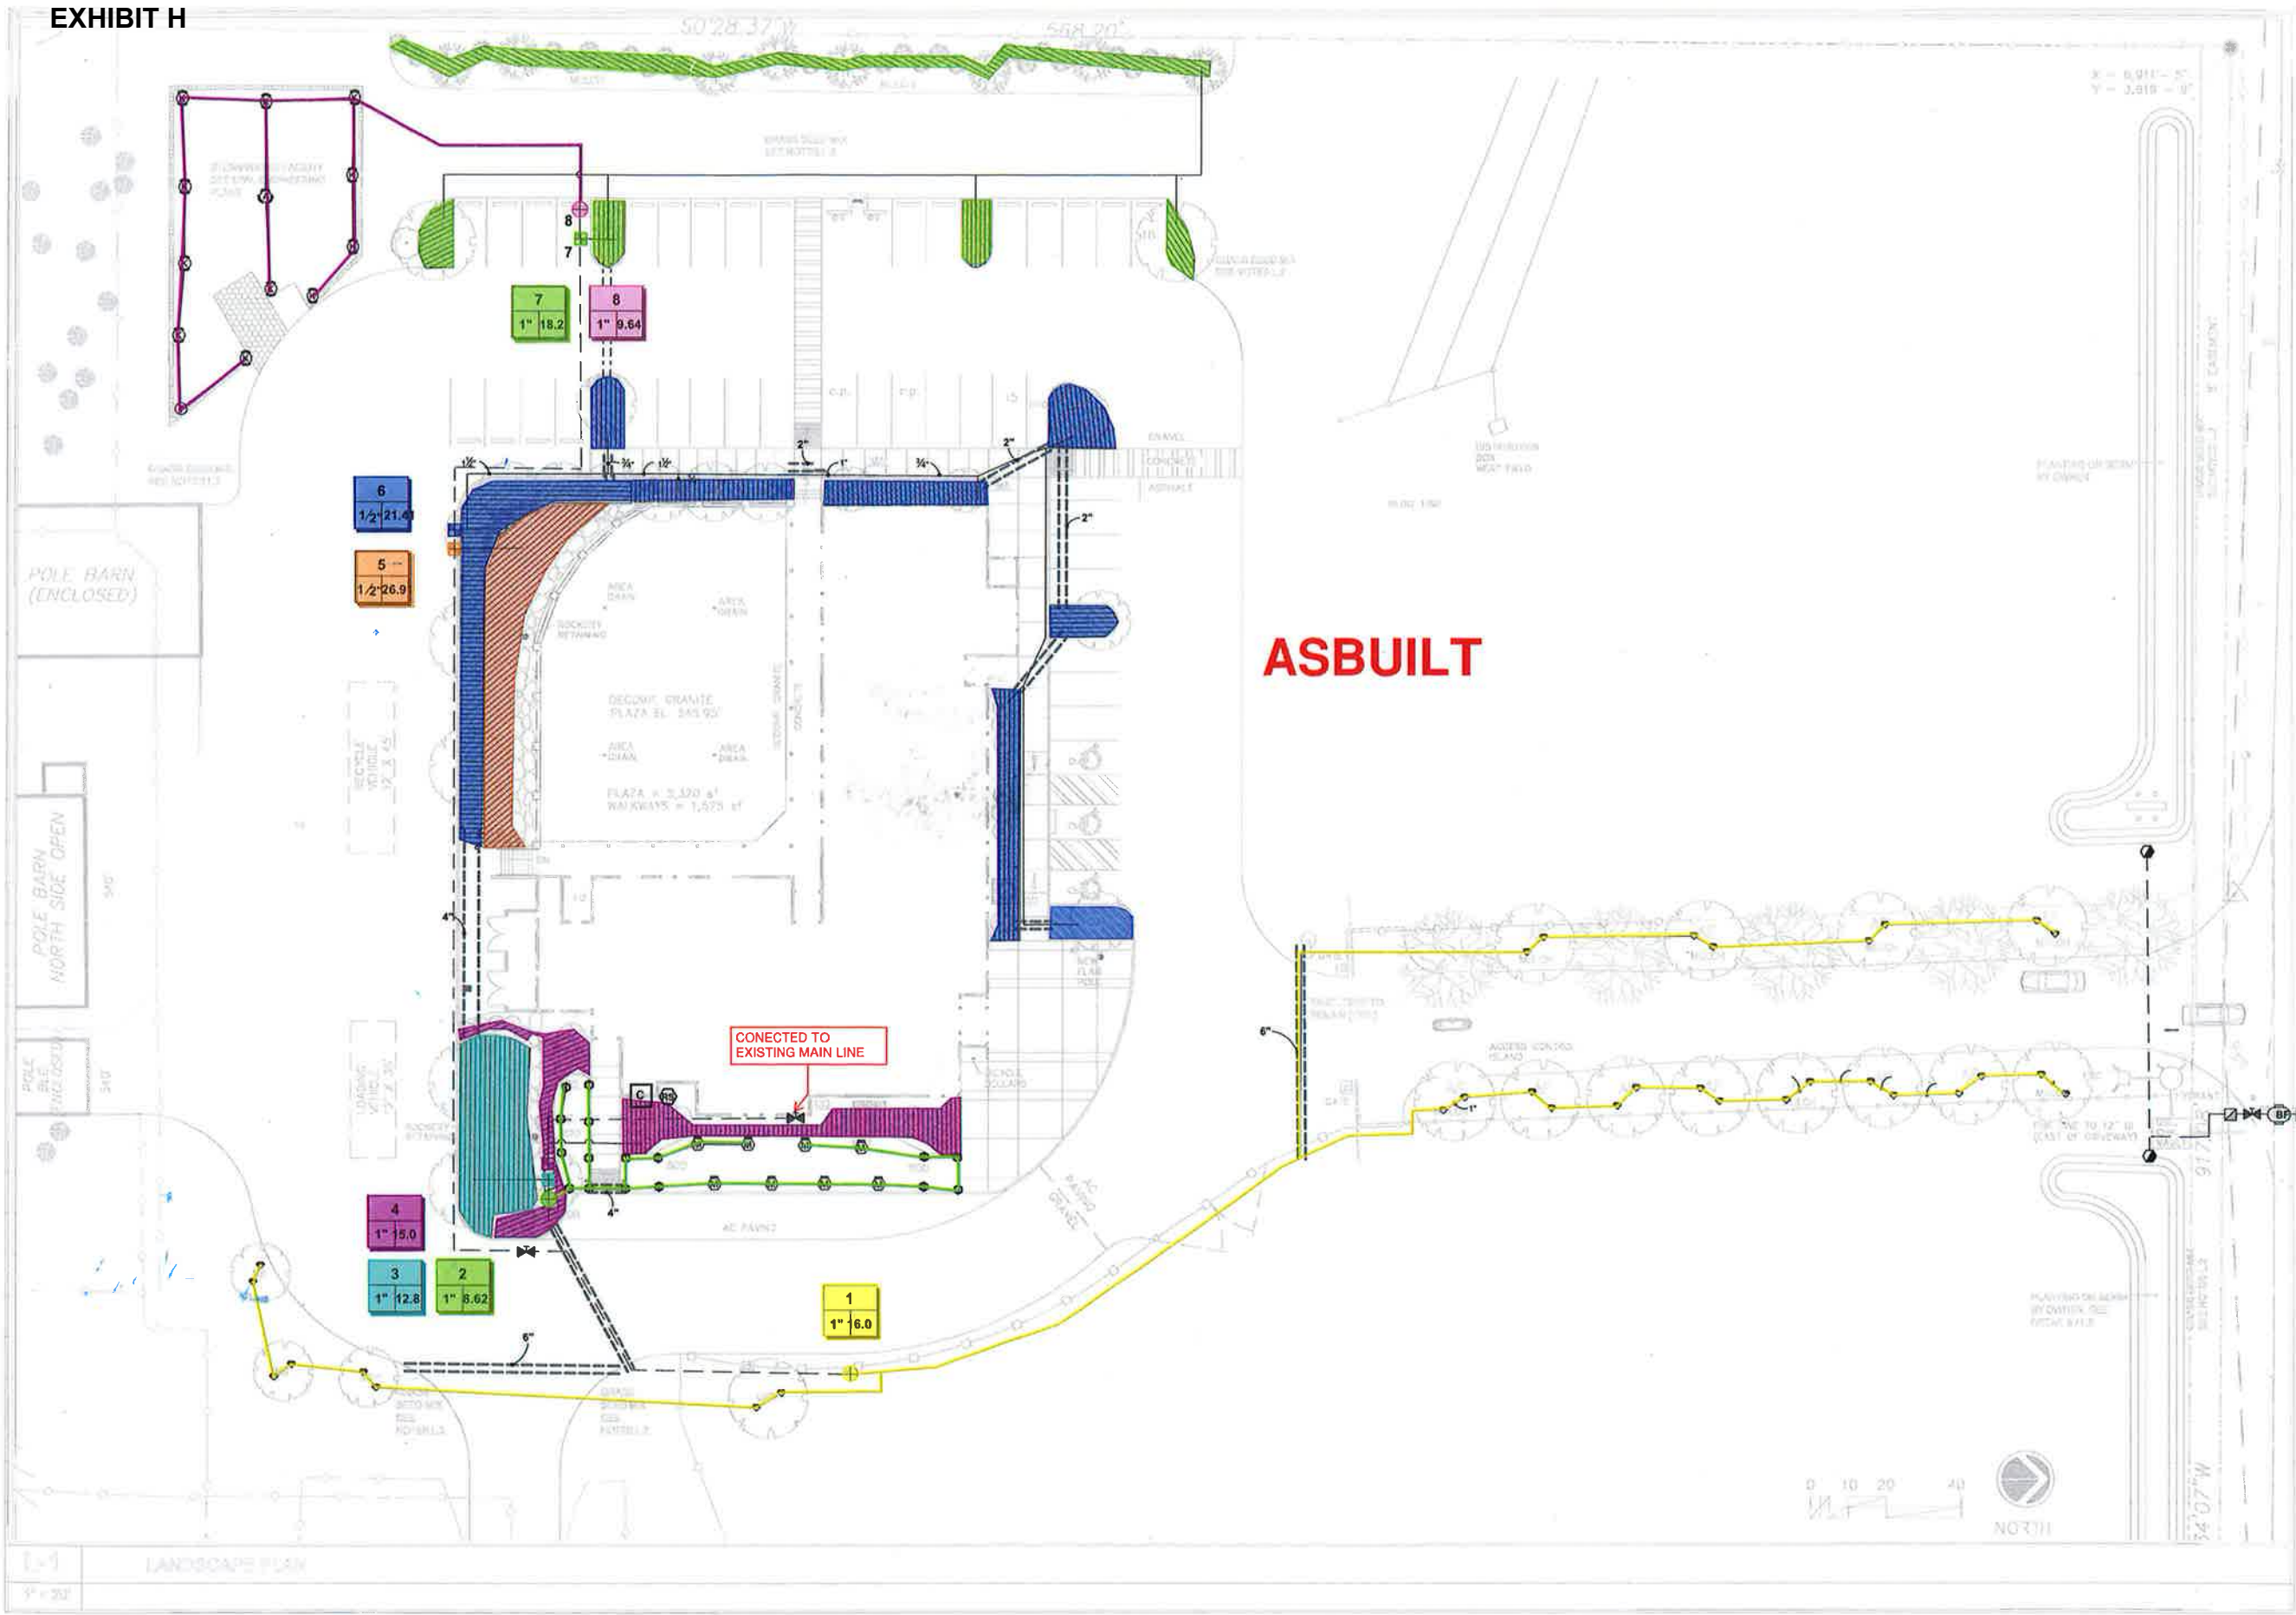

| | | | | |
|---|-------------|--|----------|--|
| REVISIONS | Date | 2/4/2020 | Approved | |
| | Description | | | |
| File No. | | ASBUILT | | |
| Sheet 1 of 1 | | | | |
| CEDAR LANDSCAPE CONSTRUCTION, INC. | | LANDOWNER CONSERVATION RESOURCE CENTER City, Maryland Address | | |
| Designed | MM/YY | Approved Title _____ Date _____ Job Class _____ | | |
| Drawn | | | | |