

1880 WILLAMETTE FALLS DR.
SUITE 200-D
WEST LINN, OR 97068

Tom Watton (503)-655-1001
Larry Fritzie (503)-655-3040
4sight503@gmail.com



DESIGNED BY

DRAWN BY

CHECKED BY _____

REVIEWED BY

DATE 11-6-2018

SCALE $1/8" = 1'-$

	Clarification #2, Signage & Casework	3-28-19
	Plan Check & Owner Revisions	2-4-19
	P&C Clarification #1	11-3-18
NUMBER	REVISIONS/SUBMISSIONS	DATE

SHEET NOTES:


NEW CONSERVATION
RESOURCE
CENTER
for
CLACKAMAS
SOIL AND WATER
CONSERVATION
DISTRICT

22055 S. BEAVERCREEK RD.
BEAVERCREEK, OR 97004

PROPOSED FLOOR PLAN

SHEET NUMBER:

A1.1

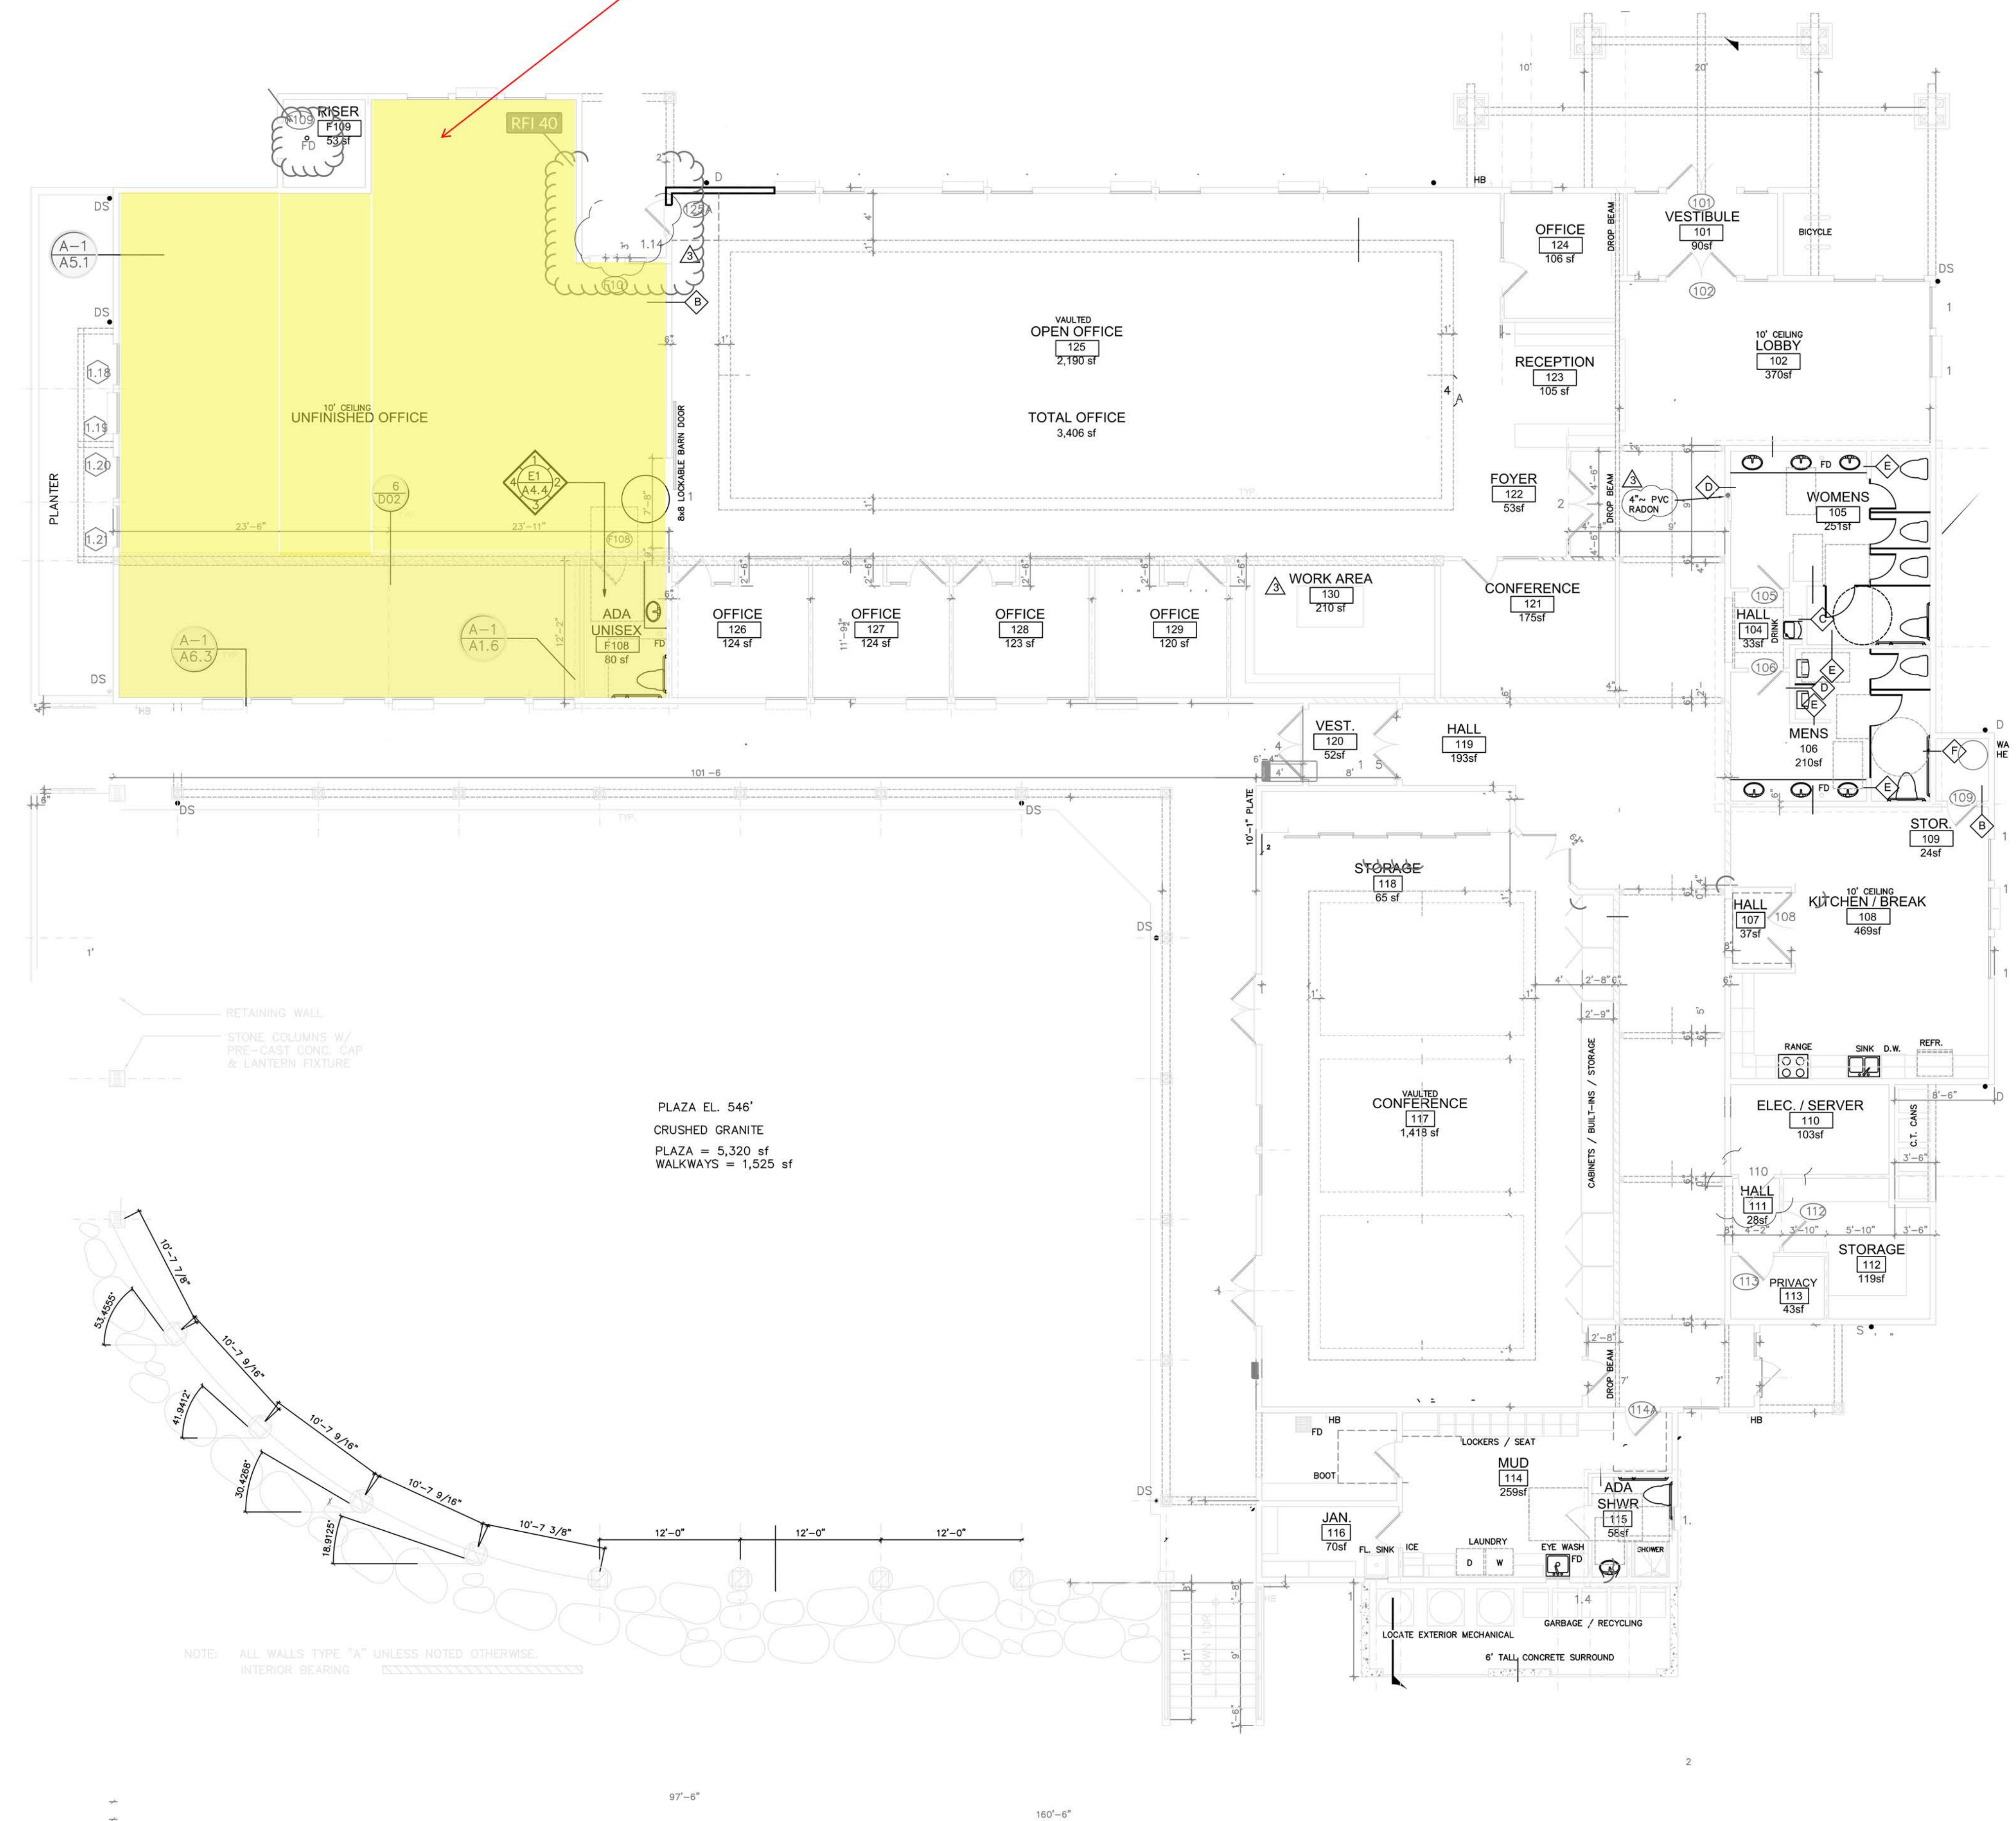


NORTH

A-1


$$1/8'' = 1'-0''$$

FLOOR PLAN

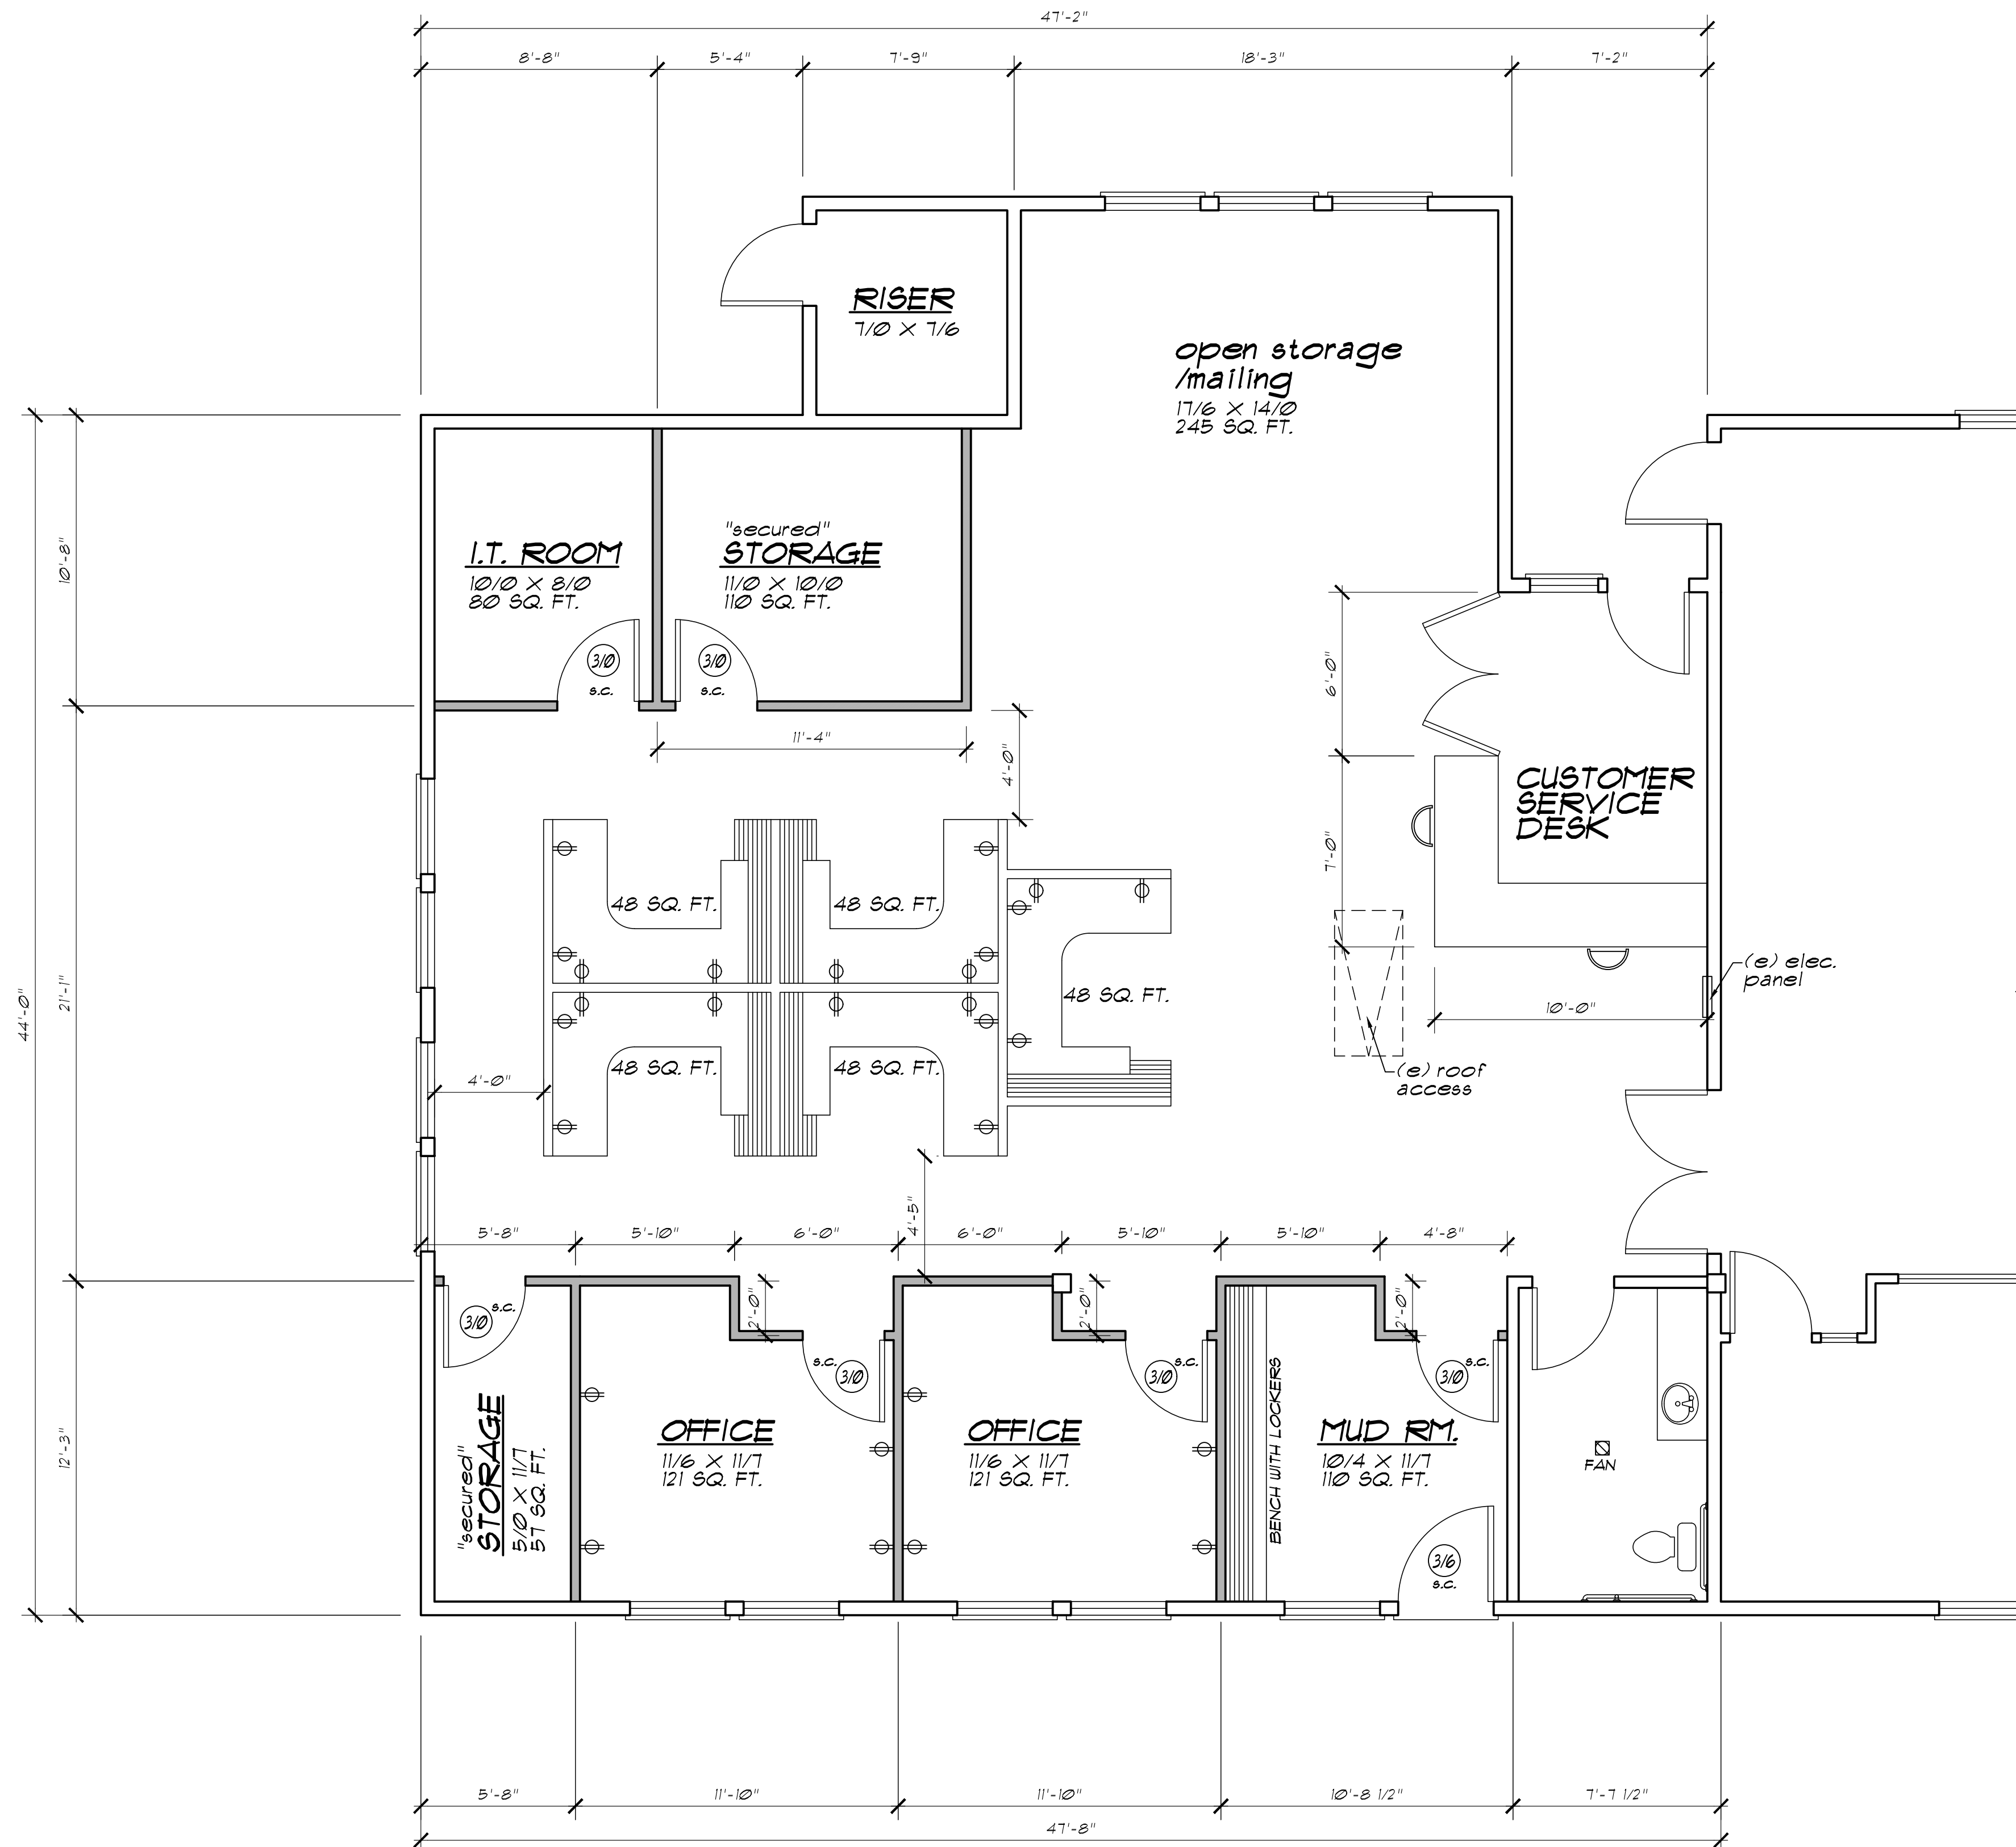

MAIN FLOOR PLAN
SCALE: 1/4" = 1'-0"
XXXX SQ. FT.

ZED DESIGN LLC ASSUMES NO RESPONSIBILITY FOR THE ACCURACY / VALIDITY OF CONTRACTOR / OWNER SUPPLIED INFORMATION. THE CONTRACTOR / OWNER IS RESPONSIBLE TO CHECK THE PLANS, EXISTING SITE CONDITIONS, DIMENSIONS, AND TO NOTIFY THE DESIGNER OF ANY ERRORS, OMISSIONS OR DISCREPANCIES PRIOR TO THE START OF CONSTRUCTION. DISCREPANCIES MAY RESULT IN ADDITIONAL COST TO THE OWNER.

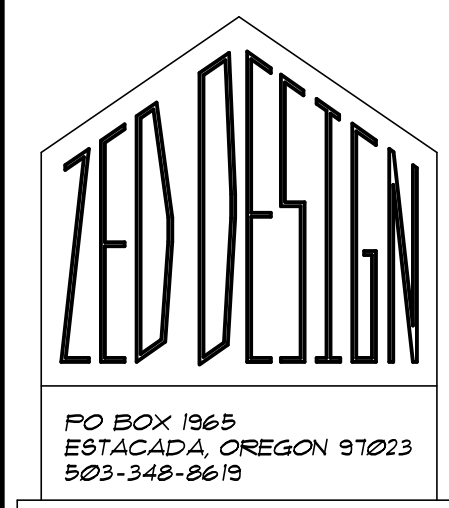

TITLE: MAIN FLOOR PLAN
PROJECT: WATER CONSERVATION DISTRICT
OWNER: CLACKAMAS SWCD
22055 S BEAVERCREEK RD.
OREGON CITY OR

DATE: AUGUST 25, 2020
PROJECT NO.: 20-100-123
REVISIONS: